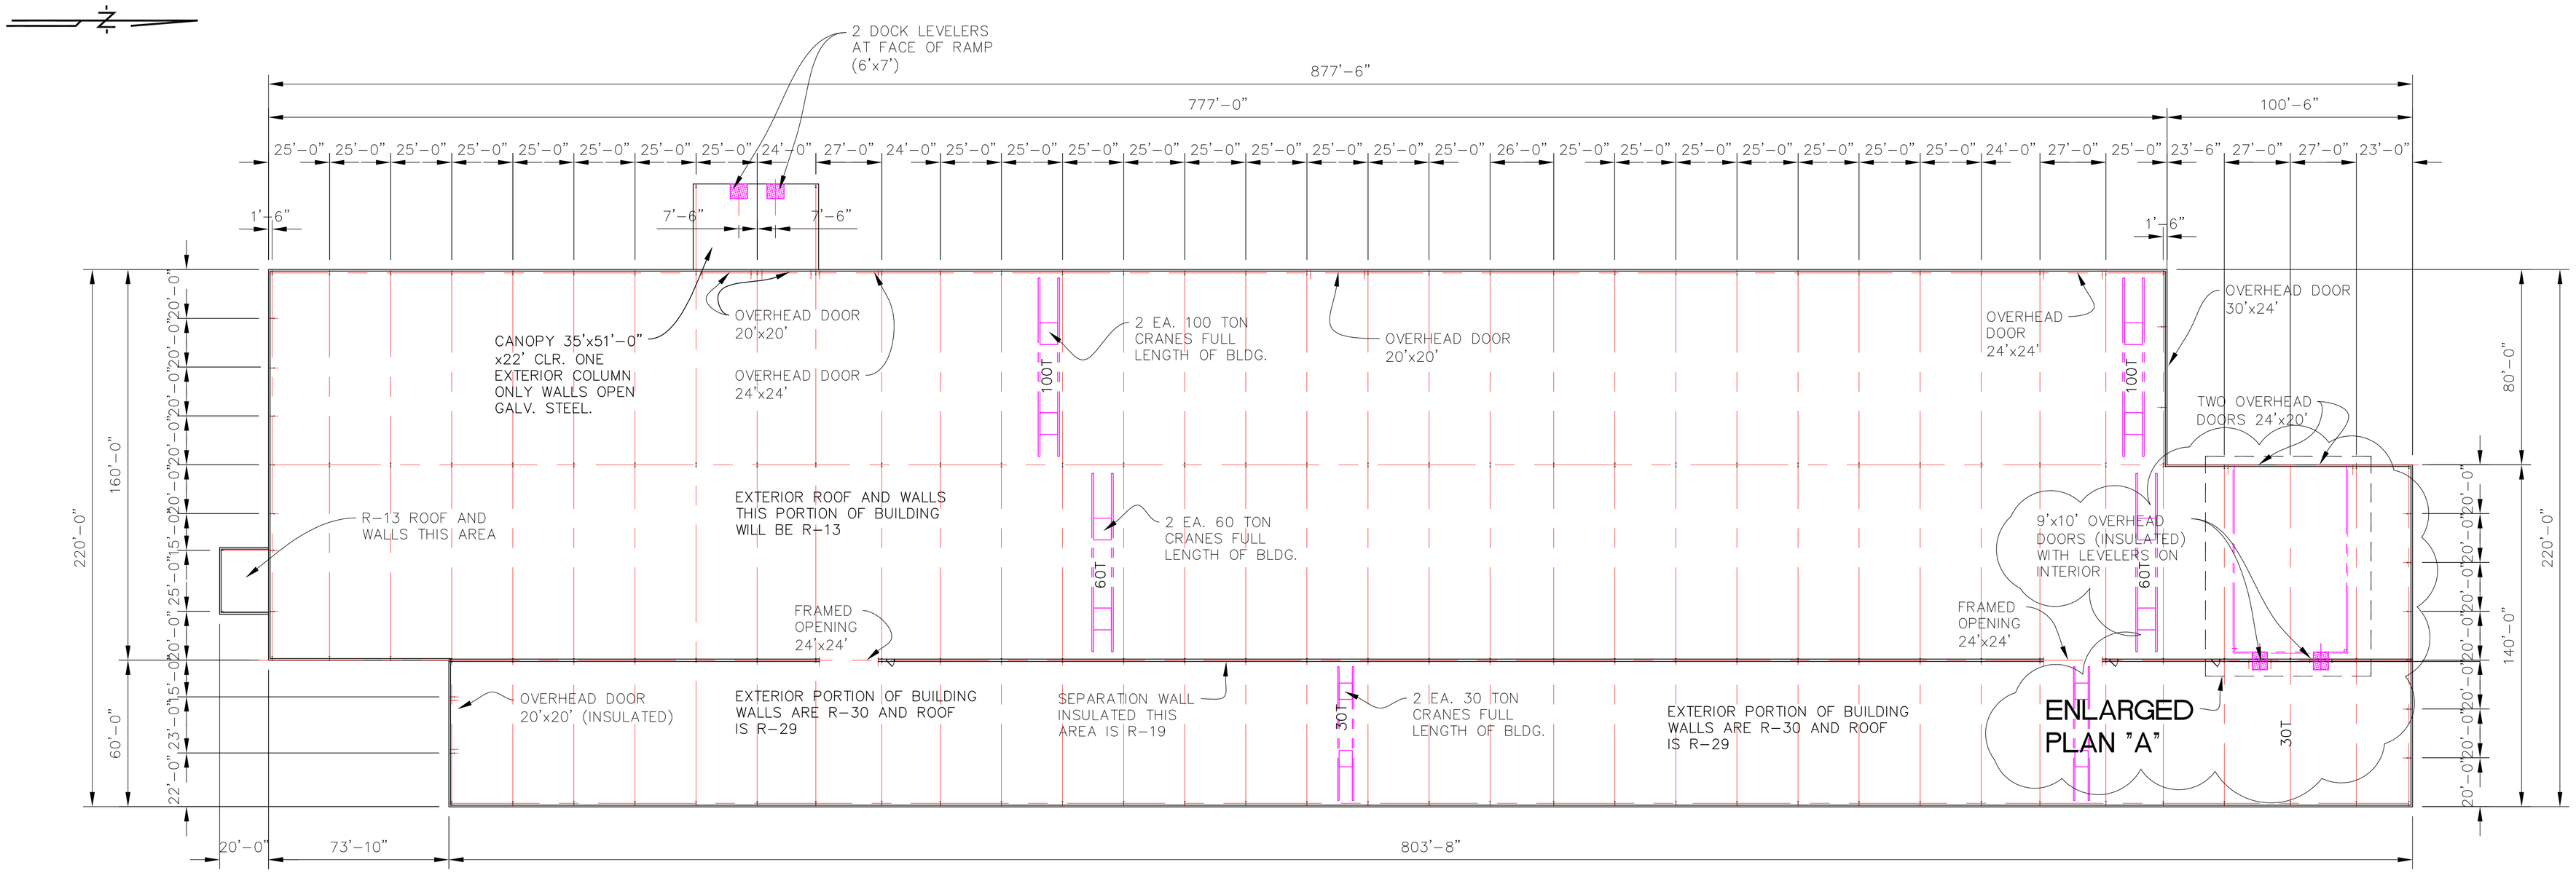

FLOOR PLAN

(PROPOSED)

SCALE: $\frac{1}{32}$"=1'-0"

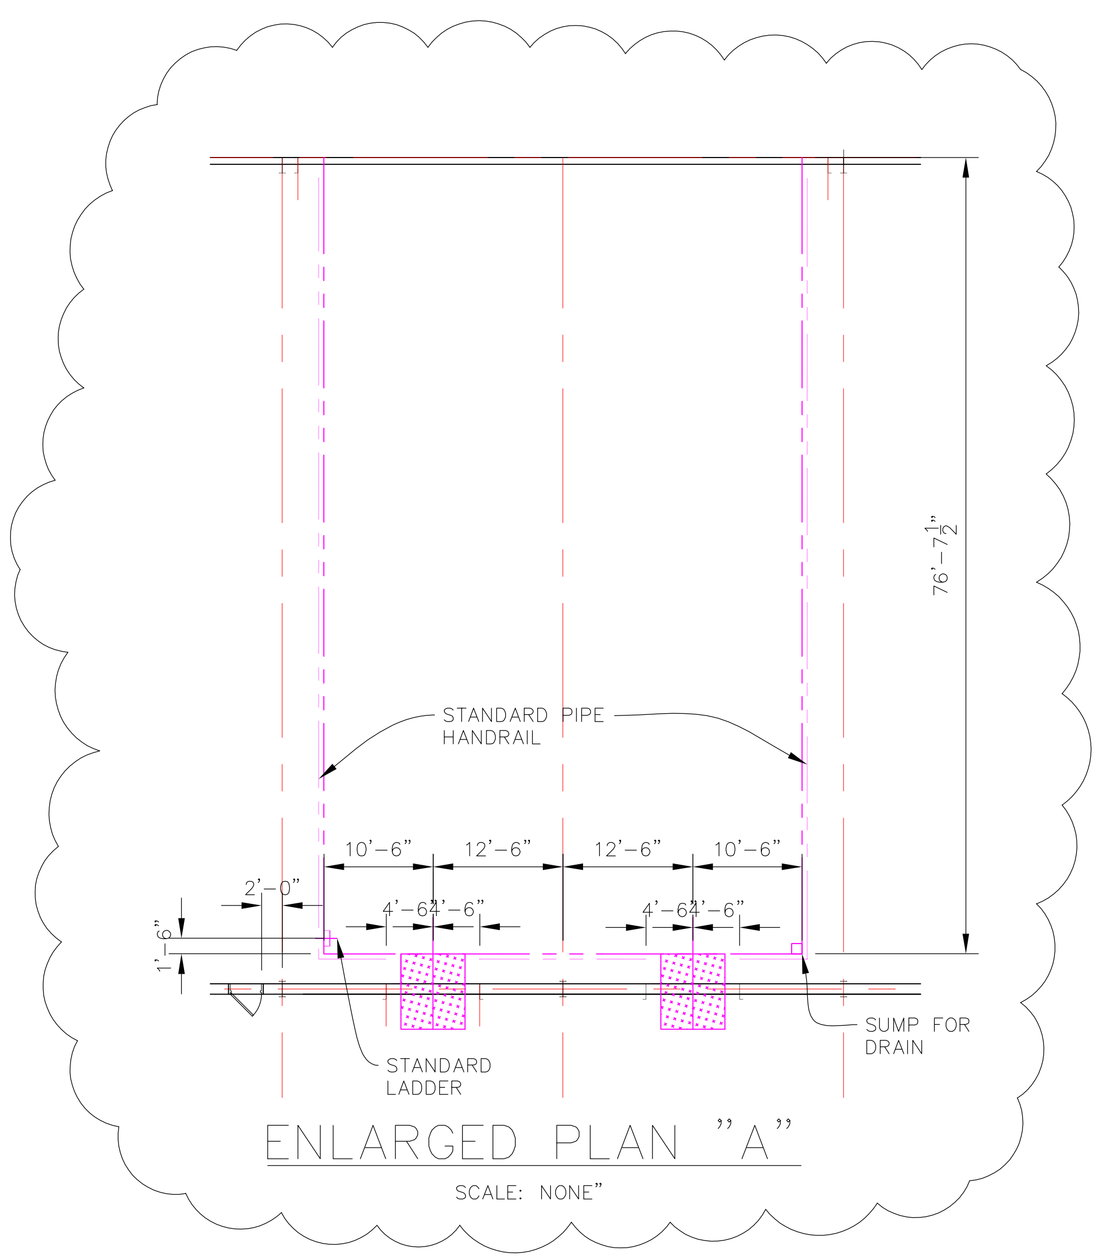

ENLARGED PLAN "A"

SCALE: NONE"

PRELIMINARY DESIGN

NOT FOR CONSTRUCTION

REV.	DATE	DESCRIPTION	DRAWN BY	APPR'D.
A	06/09/2019	REVISED PER MARKUP Q9-322	DMP	RJB
B	06/18/2019	REVISED PER MARKUP DATED 6/18/2019	DMP	RJB
C	08/15/2019	REVISED PER METALIC COLUMN LINES	DMP	RJB
D	08/21/2019	ADDED DETAILS AT RAMP INSIDE BLDG.	DMP	RJB

EMC SERVICES, INC.
Engineering, Management, and Construction
5543 ARMOUR DRIVE HOUSTON, TEXAS 77020
TEXAS BOARD OF PROFESSIONAL ENGINEERS FIRM'S LICENSE NUMBER F-4036

DIXIE CULLEN
9100 MISSISSIPPI ST.
BUILDING LAYOUT
PLAN

DATE	SCALE	DRAWING NUMBER	REV.
03/28/2019	NONE	19-111-AA-001	D